

Bakery Egypt

Production zone of the KITCHEN plan of 19-10-2026, Modern Metalica

Purpose

Three layout scenarios to produce only:
basic croissants, sandwich bread and burger buns.
Cold rooms and storage: elsewhere in the project.


What changes: space

Version B takes over the Meat area: 12.45 m2 more, 1.9 times the area of A.
Two operating options to decide: Bakery alone in the whole zone,
or Meat and Bakery in the same room, on staggered hours (hygiene sign-off needed).

Version A: 14.25 m2




Version C: 17.7 m2

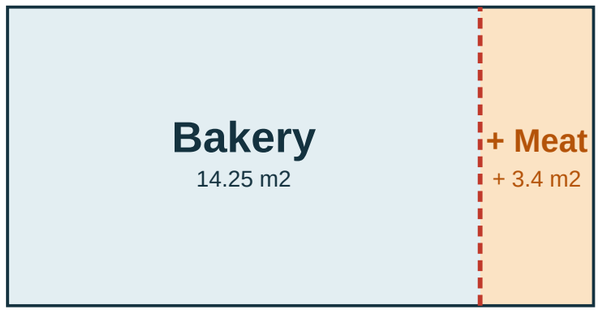

Version B: 26.7 m2

The three scenarios are shown at the same scale

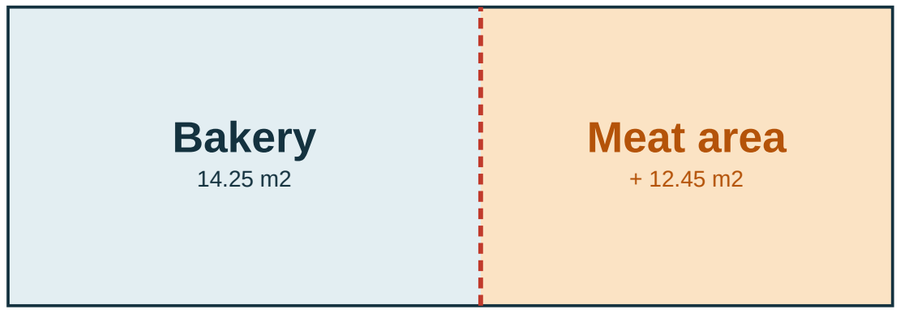

VERSION A, COMPACT

One oven: Krystal 46.9V convection.
40 L mixer, 1-trolley proofer, sheeter.
Divider, Fonto 60 water chiller.
Flour table, hand basin.
No refrigerator: it does not fit.
No wall to break.


VERSION C, INTERMEDIATE

Same equipment as A,
plus the refrigerator.
+ 1 m taken from the Meat area.
One wall to break, one new partition.
A single 1,190 mm entrance.

VERSION B, ENLARGED

Two ovens: rotary + convection.
80 L mixer, proofer, sheeter on stand.
Two tables, freezer and refrigerated cabinets.
Whole Meat area taken over.
A single wall to break.
A single 1,190 mm entrance.

Following pages: plans on the layout, equipment library, dimensioned plans with flows and staff, estimated price list in SAR excl. VAT (NABAT v5.0, Bongard / BME).
Bongard/BME machine dimensions are estimated, to be confirmed on datasheets. Production volumes: see page 11.

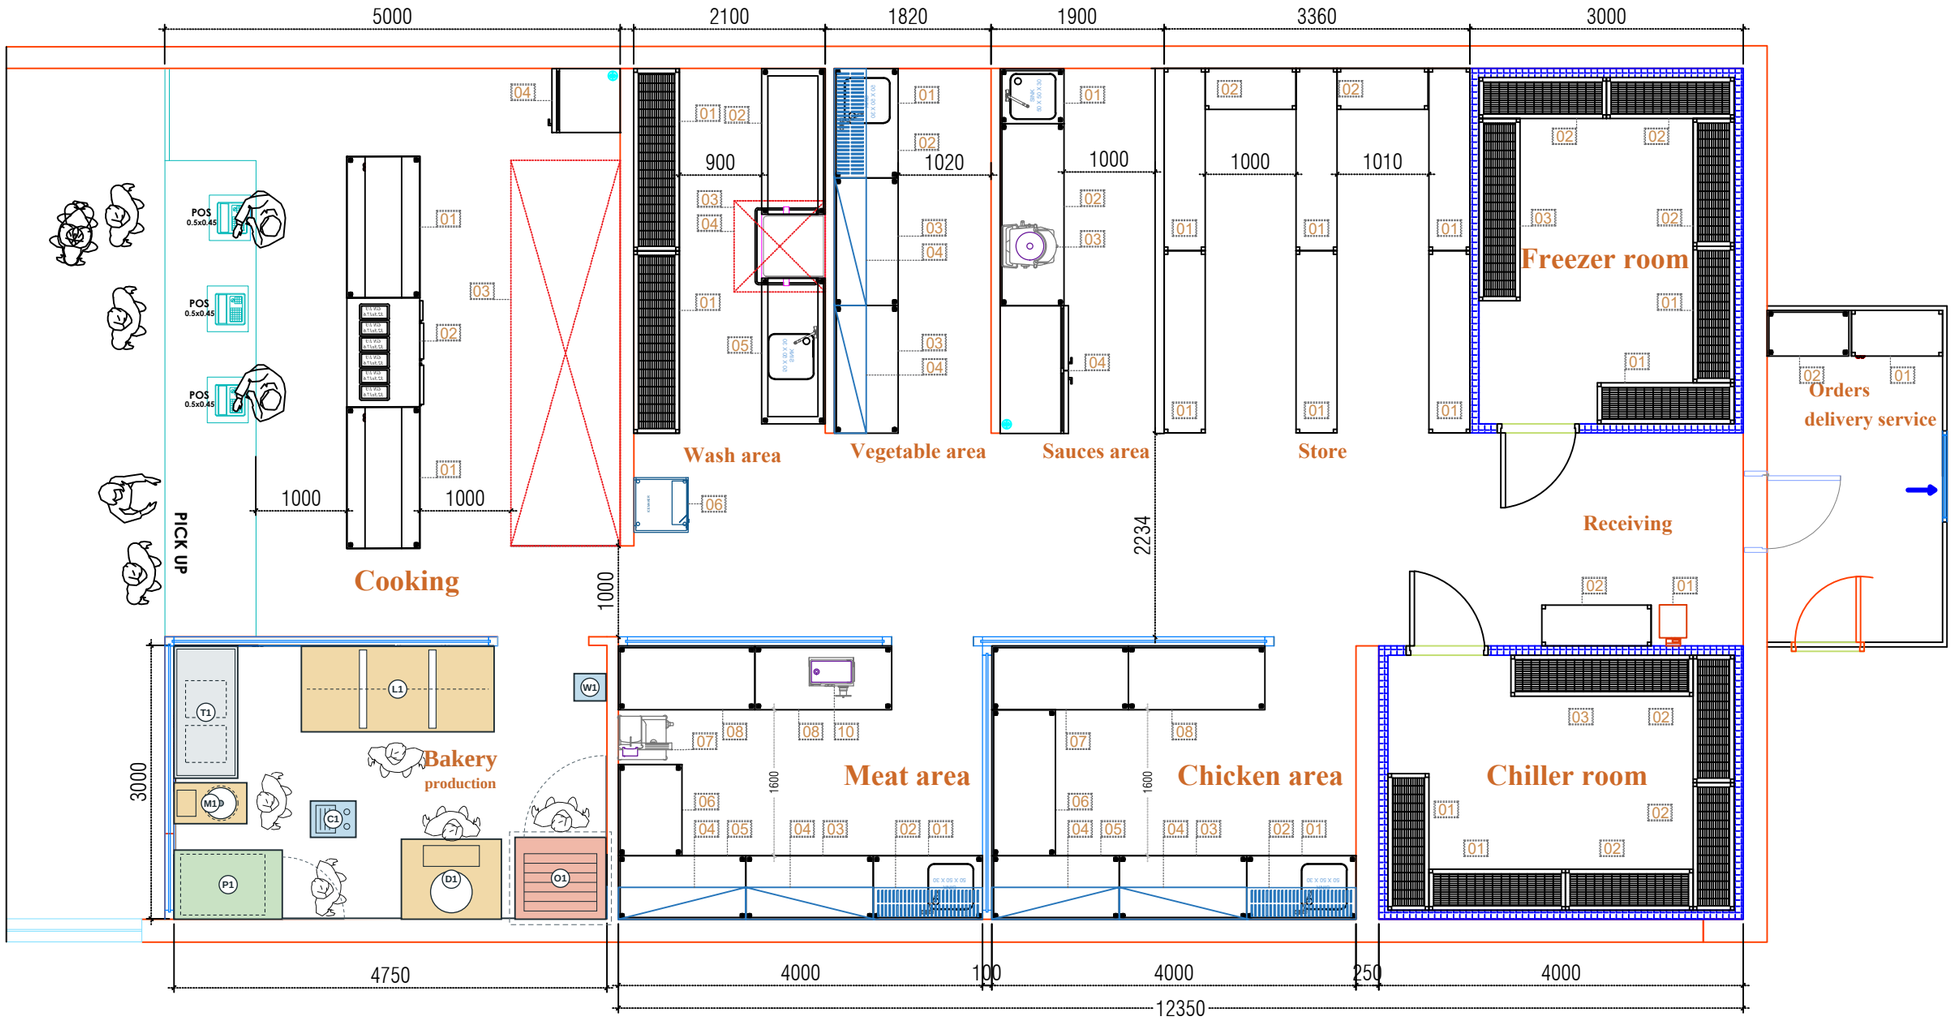

L1 Sheeter 2120 x 940
W1 Hand basin 350 x 300
P1 Proofer 1190 x 760

O1 Convection 1000 x 900
D1 Divider 1100 x 880
T1 Table + flour 700 x 1450

M1 Mixer 40 800 x 450
C1 Chiller 500 x 400

Dimensions east-west x north-south, in mm. Same numbers as on the detail pages. Existing walls kept, except the wall marked in red.

BAKERY PRODUCTION - VERSION A (COMPACT, 14.25 m2)


General Notes :

Client Name :
Location :
Scale : 1/50
Date : 31-01-2026

Drawn By : BN.DESIGN
Check By :
Approved By :

Project Name
KITCHEN

Modern Metalica

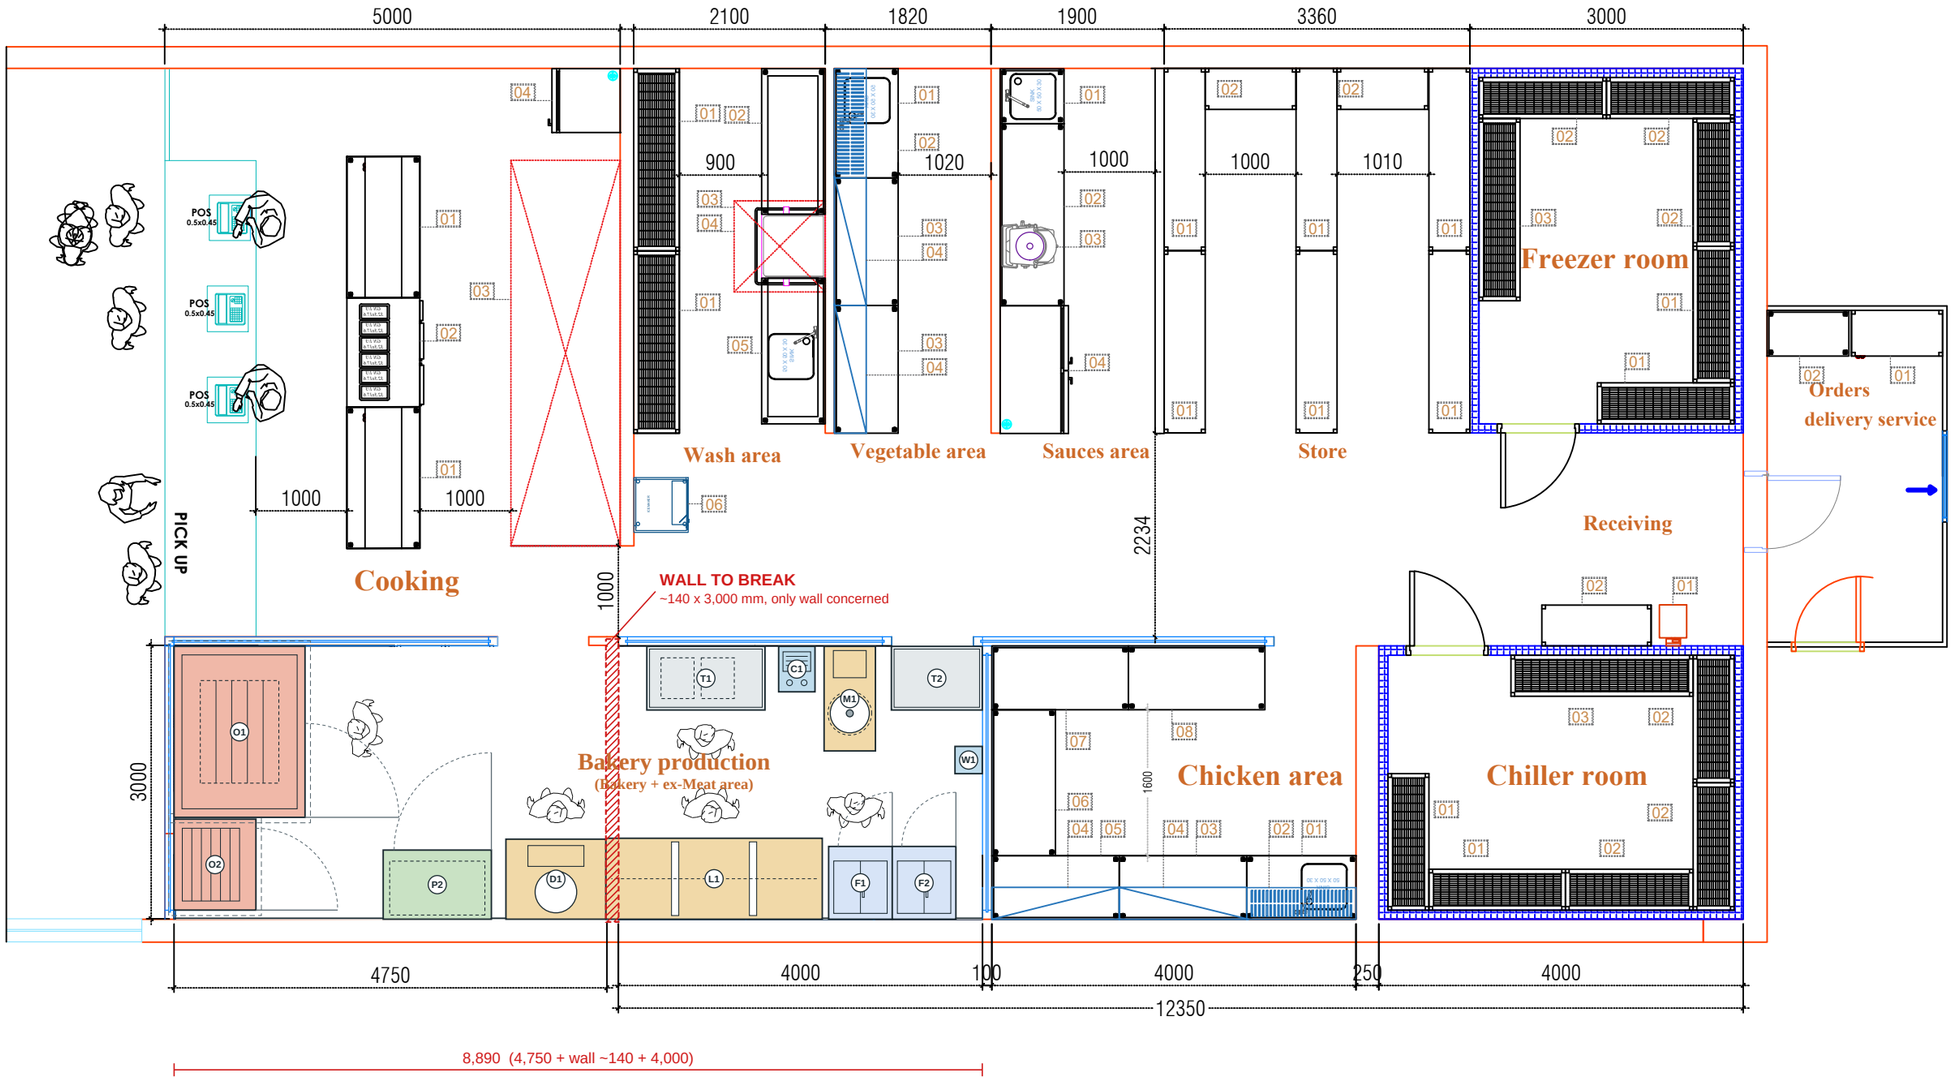

(O2) Convection 900 x 1000
(P2) Proofer 1190 x 760
(O1) Rotary oven 1440 x 1880
(D1) Divider 1100 x 880

(L1) Sheeter 2380 x 890
(T1) Table + flour 1300 x 700
(C1) Chiller 400 x 500
(M1) Mixer 80 565 x 1150

(W1) Hand basin 300 x 300
(F1) Freezer 700 x 800
(F2) Fridge 700 x 800
(T2) SS table 1000 x 700

Dimensions east-west x north-south, in mm. Same numbers as on the detail pages. Existing walls kept, except the wall marked in red.

BAKERY PRODUCTION - VERSION B (BAKERY + MEAT AREA, 26.7 m2)


General Notes :

Client Name :
Location :
Scale : 1/50
Date : 31-01-2026

Drawn By : BN.DESIGN
Check By :
Approved By :

Project Name
KITCHEN

Modern Metalica

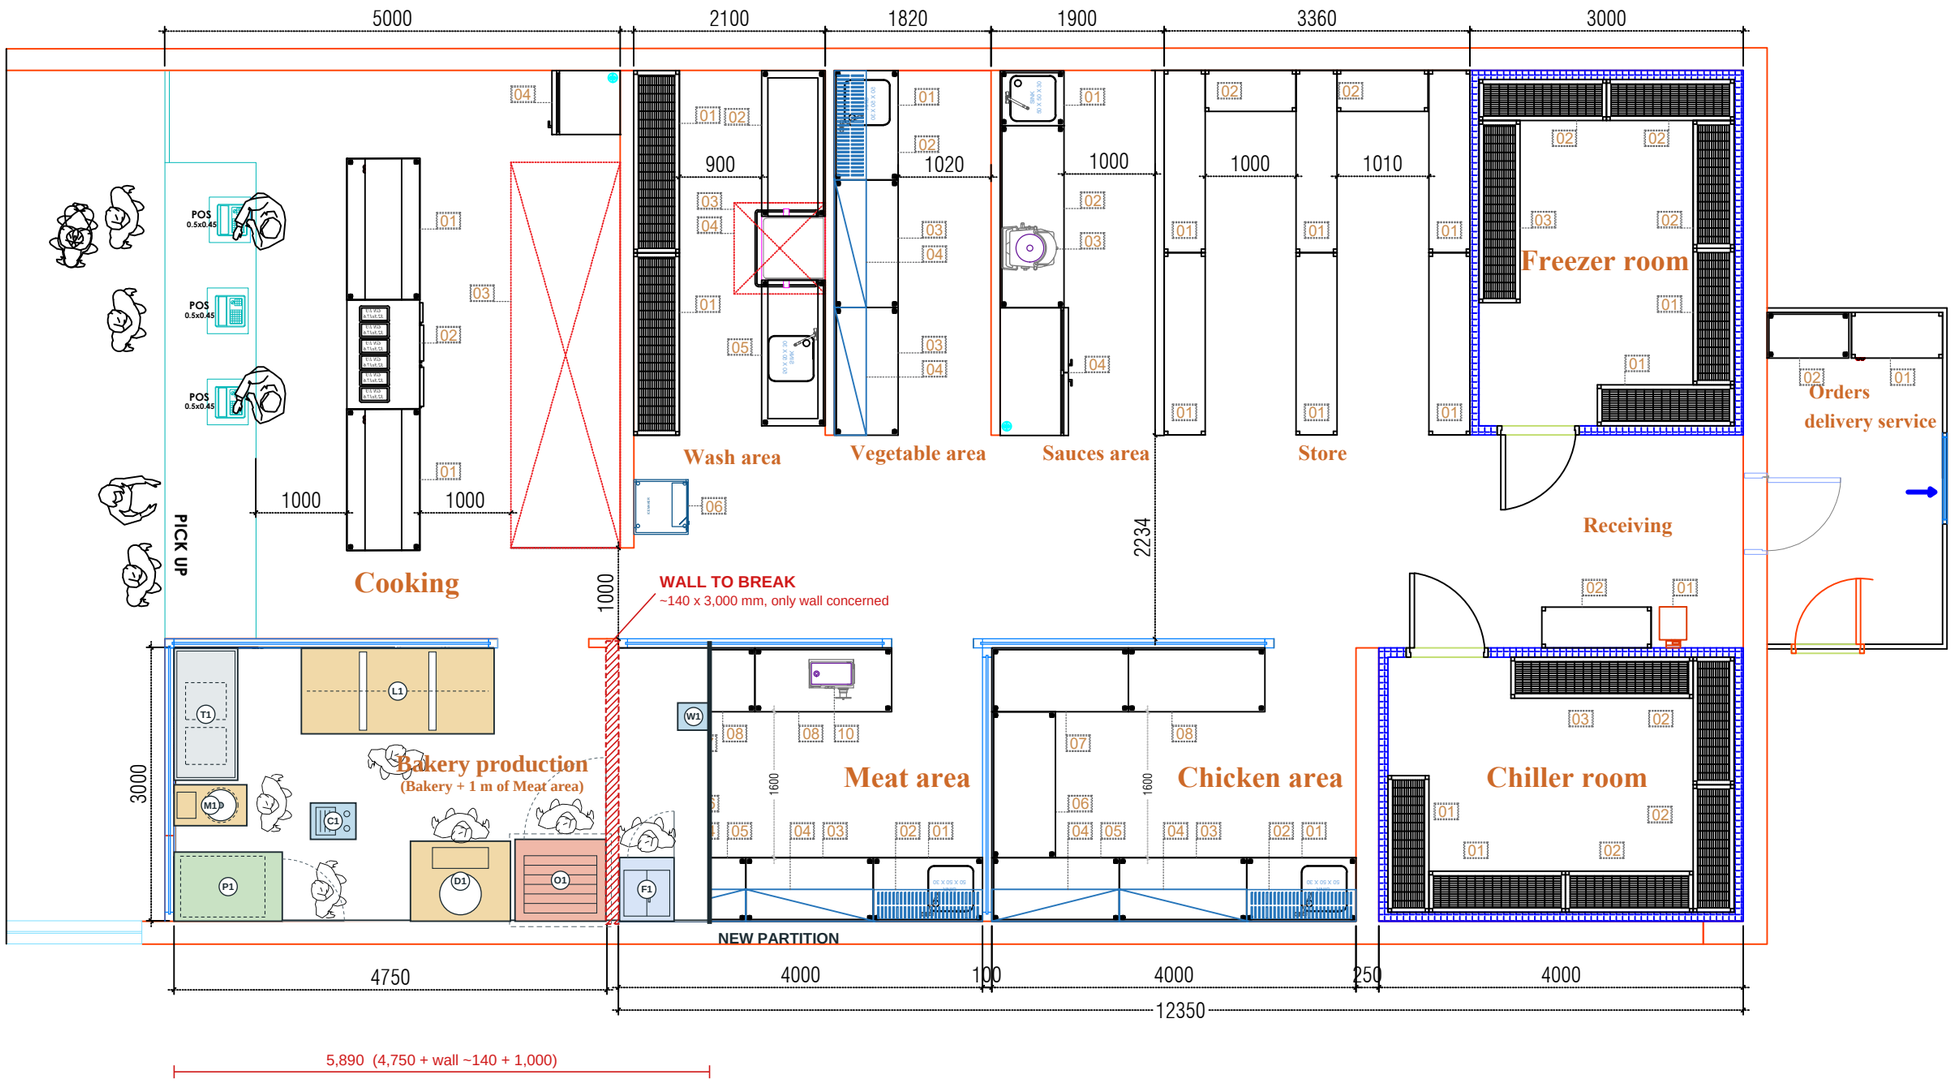

L1 Sheeter 2120 x 940
W1 Hand basin 350 x 300
P1 Proofer 1190 x 760

O1 Convection 1000 x 900
D1 Divider 1100 x 880
T1 Table + flour 700 x 1450

M1 Mixer 40 800 x 450
C1 Chiller 500 x 400
F1 Fridge 600 x 700

Dimensions east-west x north-south, in mm. Same numbers as on the detail pages. Existing walls kept, except the wall marked in red.

BAKERY PRODUCTION - VERSION C (INTERMEDIATE, 17.7 m2)

General Notes :

Client Name :
Location :
Scale : 1/50
Date : 31-01-2026

Drawn By : BN.DESIGN
Check By :
Approved By :

Project Name

KITCHEN

Modern Metalica


Equipment diagrams, version A

Top view, one diagram per appliance. A single oven in this version: Krystal 46.9V convection.

KITCHEN - Bakery Egypt

04-11-2026 - scale shown on each plan

L1

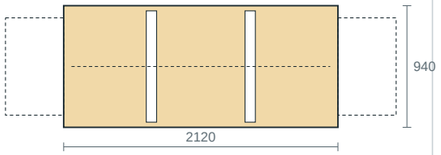


Rhea MANU-T 500 sheeter (ref. AF000047424)

Estimated

Front 2120 x depth 940 mm
220 V 1PH, ~0.5 kW
—

W1

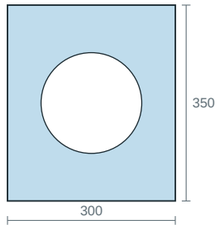


Wall hand basin

Estimated

Front 300 x depth 350 mm
—
Cold + hot water, drain

P1

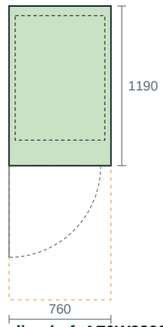


HERA-C proofer, 1 trolley (ref. AF0W9200516)

OLBA list

Front 760 x depth 1190 mm
220 V 1PH, ~2 kW (est.)
Water ½", drain

O1

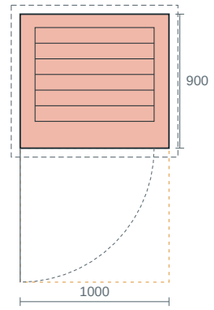


Krystal 46.9V convection oven (ref. AF072100273)

Estimated

Front 1000 x depth 900 mm
380 V 3PH, ~16 kW (est.)
Water ½" (steam), drain, hood

D1

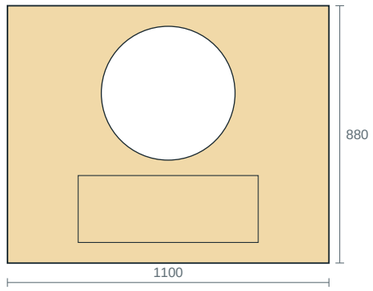


Eris FA divider-rounder (ref. AF00I103012)

Estimated

Front 1100 x depth 880 mm
220 V 1PH, ~1.3 kW
—

T1

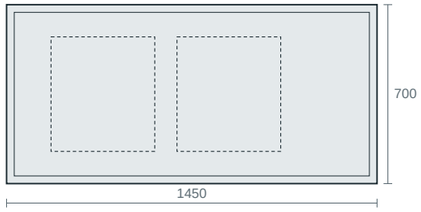


Work table with flour bins

Plan BOQ dimension

Front 1450 x depth 700 mm
—
—

M1

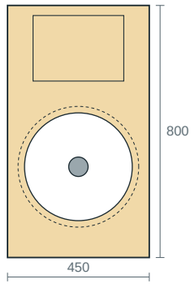


Spiral mixer 40 L (model to be confirmed)

Estimated

Front 450 x depth 800 mm
380 V 3PH, ~2 kW (est.)
—

C1

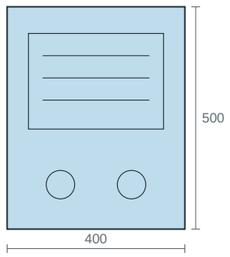

Fonto 60 water chiller (ref. AF014100044)

Estimated

Front 400 x depth 500 mm
220 V 1PH 60 Hz, ~0.3 kW (est.)
Filtered water ½", drain

Mixing, sheeting, shaping · Water · Baking · Tables · Proofing · Racks, shelves · Cold

Orange dotted: trolley loading zone. Grey dotted: hood. Arc: door swing.

Generic diagrams by appliance type, redrawn from the dimensions. They are not the manufacturers' top views.
Sources: KITCHEN plan of 19-10-2026 (dimensions 4,750, 3,000, 4,000 and openings taken from the PDF). Equipment: see dimension status.


Equipment diagrams, version B

Version B appliances: Bongard 8.64 E rotary oven, Krystal convection oven, sheeter on stand, 80 L spiral mixer, HERA-C proofer, freezer and refrigerated cabinets.

KITCHEN - Bakery Egypt

04-11-2026 - scale shown on each plan

O2

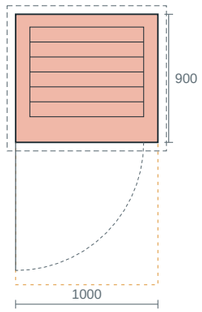


Krystal 46.9V convection oven (ref. AF072100273)

Estimated

Front 1000 x depth 900 mm
380 V 3PH, ~16 kW (est.)
Water ½", drain, hood

P2

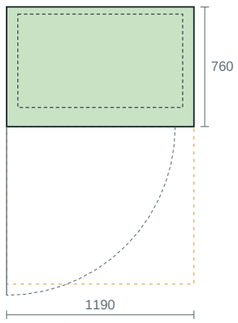


HERA-C proofer, 1 trolley (ref. AF0W9200516)

OLBA list

Front 1190 x depth 760 mm
220 V 1PH, ~2 kW (est.)
Water ½", drain

O1

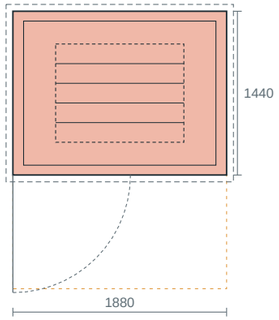


Bongard 8.64 E rotary oven (ref. AF056200013)

Catalogue sheet

Front 1880 x depth 1440 mm
Electric 57 kW (E version)
Water ½", drain, hood. Gas version 8.64 MG: 70 kW, gas point to be created

D1

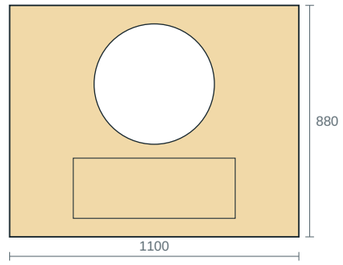


Eris FA divider-rounder (ref. AF00I103012)

Estimated

Front 1100 x depth 880 mm
220 V 1PH, ~1.3 kW
—

L1

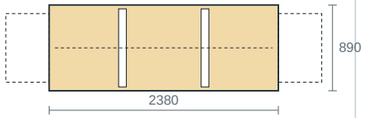


Rhea AUTO-S 650 sheeter on stand (ref. AF000048716)

Estimated

Front 2380 x depth 890 mm
220 V 1PH, 0.75 kW
—

T1

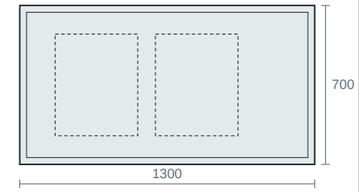


Work table with flour bins

Plan BOQ dimension

Front 1300 x depth 700 mm
—
—

C1

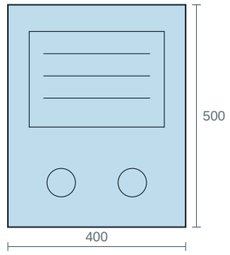


Fonto 60 water chiller (ref. AF014100044)

Estimated

Front 400 x depth 500 mm
220 V 1PH 60 Hz, ~0.3 kW (est.)
Filtered water ½", drain

M1

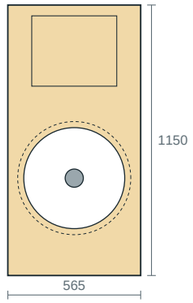


Spiral mixer 80 L (Spiral Evo 80)

OLBA list

Front 565 x depth 1150 mm
380 V 3PH, ~3.5 kW (est.)
—

W1

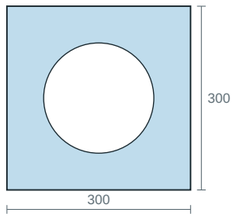


Wall hand basin

Estimated

Front 300 x depth 300 mm
—
Cold + hot water, drain

F1

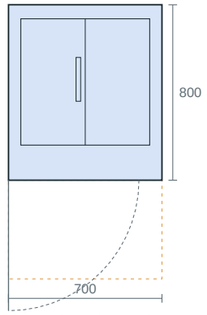


Freezer cabinet, 1 door (-18 °C)

Estimated

Front 700 x depth 800 mm
220 V 1PH, ~0.5 kW (est.)
—

F2

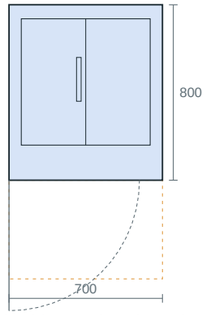


Refrigerated cabinet, 1 door (+4 °C)

Estimated

Front 700 x depth 800 mm
220 V 1PH, ~0.4 kW (est.)
—

T2

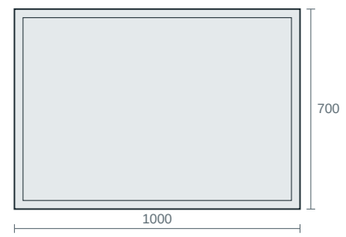

Stainless work table (1,000 x 700)

Estimated

Front 1000 x depth 700 mm
—
—

Mixing, sheeting, shaping | Water | Baking | Tables | Proofing | Racks, shelves | Cold — Orange dotted: trolley loading zone. Grey dotted: hood. Arc: door swing.

Generic diagrams by appliance type, redrawn from the dimensions. They are not the manufacturers' top views.
Sources: KITCHEN plan of 19-10-2026 (dimensions 4,750, 3,000, 4,000 and openings taken from the PDF). Equipment: see dimension status.


Equipment diagrams, version C

Same appliances as version A, plus the undercounter refrigerator.

KITCHEN - Bakery Egypt

04-11-2026 - scale shown on each plan

L1

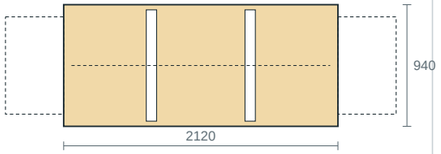


Rhea MANU-T 500 sheeter (ref. AF000047424)

Estimated

Front 2120 x depth 940 mm
220 V 1PH, ~0.5 kW
—

W1

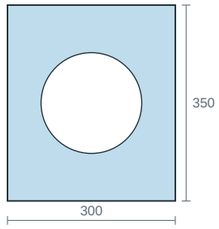


Wall hand basin

Estimated

Front 300 x depth 350 mm
—
Cold + hot water, drain

P1

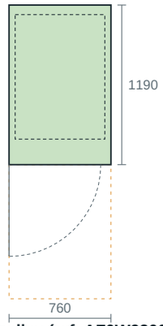


HERA-C proofer, 1 trolley (ref. AF0W9200516)

OLBA list

Front 760 x depth 1190 mm
220 V 1PH, ~2 kW (est.)
Water ½", drain

O1

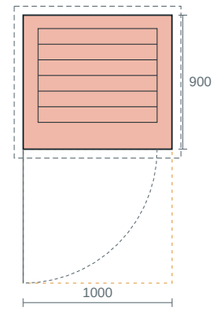


Krystal 46.9V convection oven (ref. AF072100273)

Estimated

Front 1000 x depth 900 mm
380 V 3PH, ~16 kW (est.)
Water ½" (steam), drain, hood

D1

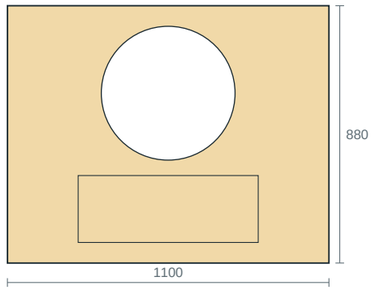


Eris FA divider-rounder (ref. AF00I103012)

Estimated

Front 1100 x depth 880 mm
220 V 1PH, ~1.3 kW
—

T1

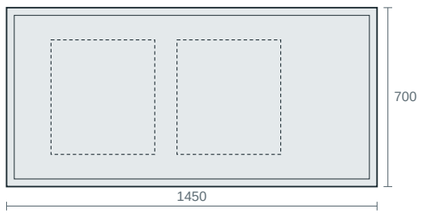


Work table with flour bins

Plan BOQ dimension

Front 1450 x depth 700 mm
—
—

M1

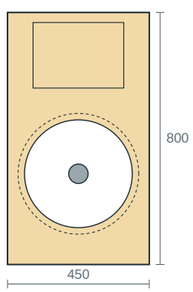

Spiral mixer 40 L (model to be confirmed)

Estimated

Front 450 x depth 800 mm
380 V 3PH, ~2 kW (est.)
—


C1

Fonto 60 water chiller (ref. AF014100044)

Estimated

Front 400 x depth 500 mm
220 V 1PH 60 Hz, ~0.3 kW (est.)
Filtered water ½", drain

F1

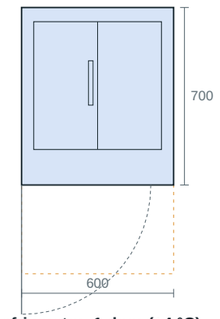

Undercounter refrigerator, 1 door (+4 °C)

Estimated


Front 600 x depth 700 mm
220 V 1PH, ~0.3 kW (est.)
—

Mixing, sheeting, shaping | Water | Baking | Tables | Proofing | Racks, shelves | Cold — Orange dotted: trolley loading zone. Grey dotted: hood. Arc: door swing.

Generic diagrams by appliance type, redrawn from the dimensions. They are not the manufacturers' top views.
Sources: KITCHEN plan of 19-10-2026 (dimensions 4,750, 3,000, 4,000 and openings taken from the PDF). Equipment: see dimension status.

Version A, detail plan

Compact production bakery, 14.25 m2, scale 1:7.7 on the sheet

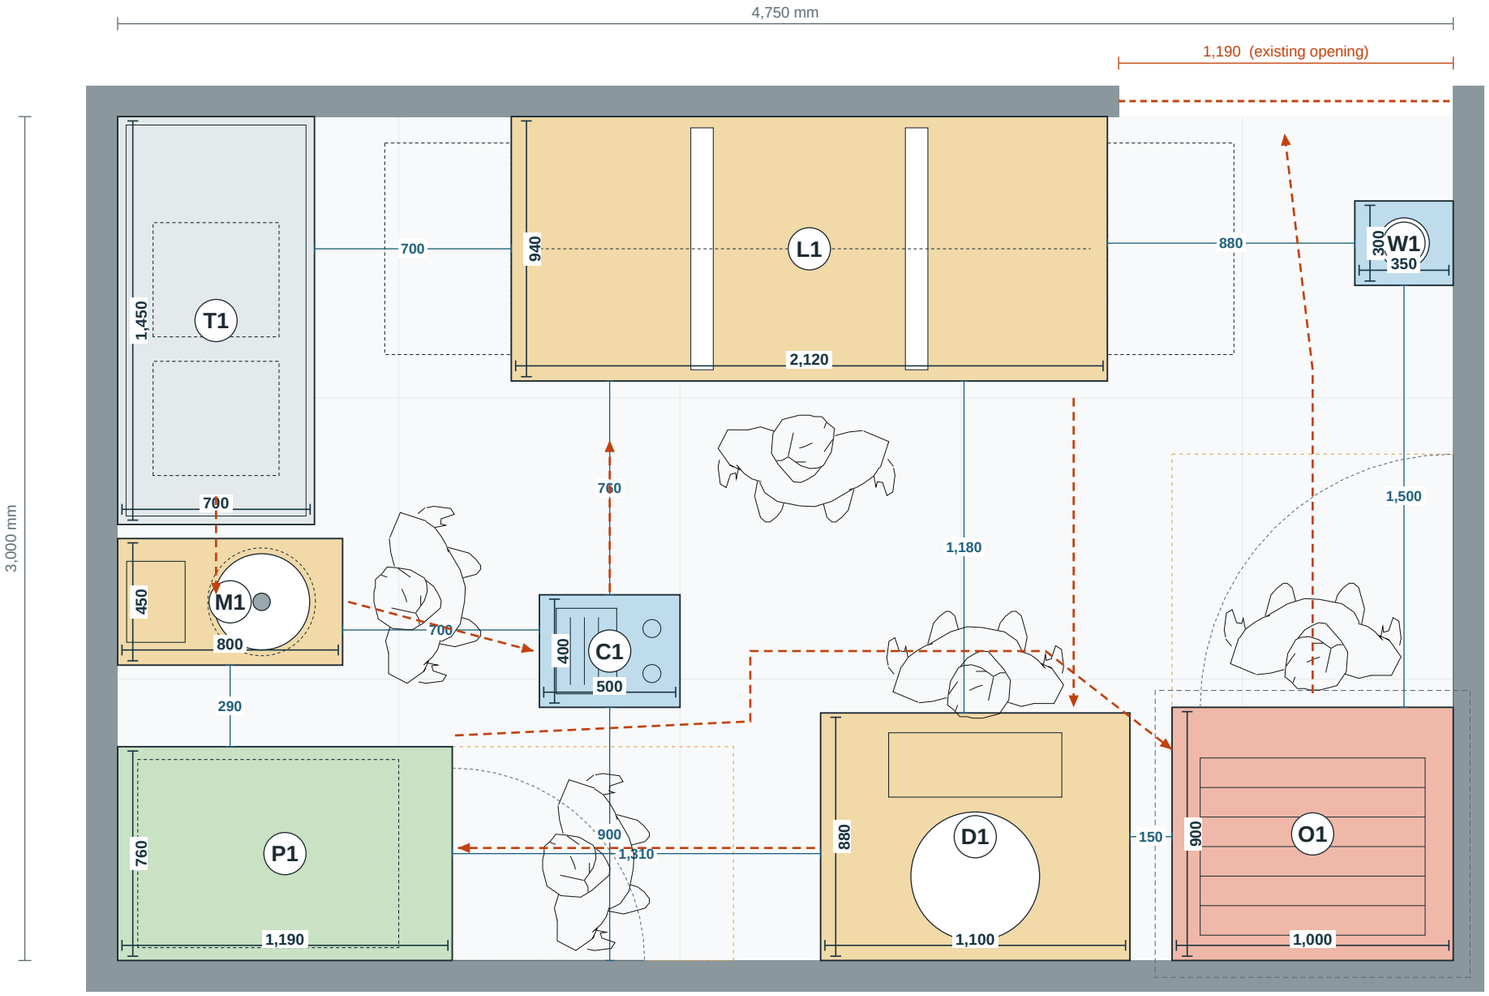

Reading the plan

- Access stays through the existing 1,190 mm north-east opening onto Cooking. No wall is touched in this version. The entrance is clear: nothing in front of the opening, and the way to the back stays free.
- Process logic: flour table (T1) then mixer (M1) side by side on the west wall, chiller (C1) next to the mixer, sheeter (L1) on the north side, divider (D1) then proofer (P1) on the west side, oven (O1) in the south-east corner. The proofer trolley reaches the oven along the north side of the divider.
- 40 L spiral mixer instead of 80 L (about 450 x 800 mm) and Fonto 60 water chiller: dimensions of the Bongard/BME machines (Fonto, Eris, Rhea, Krystal) are estimated, to be confirmed on datasheets. Price list on the last page.
- The undercounter refrigerator does not fit in the 14.25 m2 without blocking a workstation or an aisle: it is therefore absent from A, which is why version C (page 10) exists and includes it.
- Production estimate: see page 8 (about 75 to 125 kg of dough a day). Existing water points (south side) have to be moved to the chiller, proofer and oven. No gas point in the bakery.

No.	Equipment	E-W x N-S (mm)	Electrical	Water, drain, gas	Status
L1	Rhea MANU-T 500 sheeter (ref. AF000047424)	2120 x 940	220 V 1PH, ~0.5 kW	—	Estimated
W1	Wall hand basin	350 x 300	—	Cold + hot water, drain	Estimated
P1	HERA-C proofer, 1 trolley (ref. AF0W9200516)	1190 x 760	220 V 1PH, ~2 kW (est.)	Water ½", drain	OLBA list
O1	Krystal 46.9V convection oven (ref. AF072100273)	1000 x 900	380 V 3PH, ~16 kW (est.)	Water ½" (steam), drain, hood	Estimated
D1	Eris FA divider-rounder (ref. AF00I103012)	1100 x 880	220 V 1PH, ~1.3 kW	—	Estimated
T1	Work table with flour bins	700 x 1450	—	—	Plan BOQ dimension
M1	Spiral mixer 40 L (model to be confirmed)	800 x 450	380 V 3PH, ~2 kW (est.)	—	Estimated
C1	Fonto 60 water chiller (ref. AF014100044)	500 x 400	220 V 1PH 60 Hz, ~0.3 kW (est.)	Filtered water ½", drain	Estimated

Mixing, sheeting, shaping | Water | Baking | Tables | Proofing | Racks, shelves | Cold

Orange dashed arrow: production flow. Orange dotted: loading zone. Grey dotted: hood. Red hatched: wall to break. Orange line on north wall: existing opening.


Sources: KITCHEN plan of 19-10-2026 (dimensions 4,750, 3,000, 4,000 and openings taken from the PDF). Equipment: see dimension status.

Version B, detail plan

Bakery + Meat area, 26.7 m2, scale 1:9.3 on the sheet

KITCHEN - Bakery Egypt

04-11-2026 - scale shown on each plan

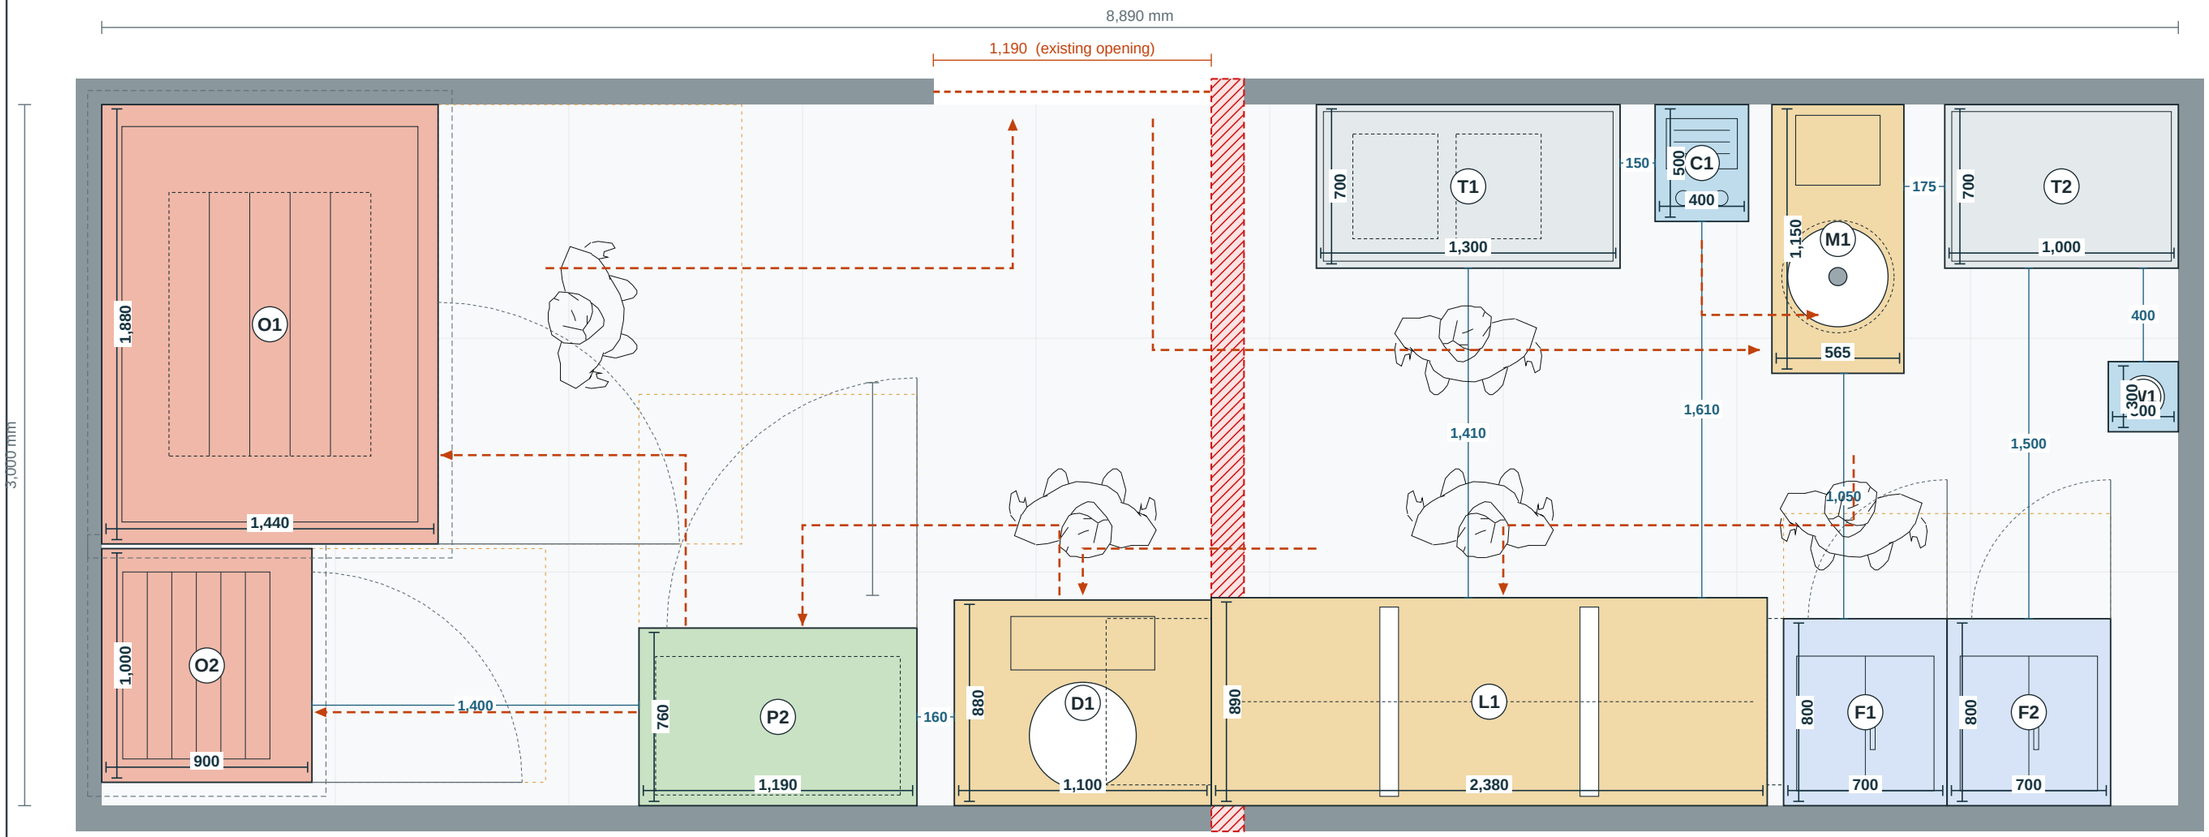

WALL TO BREAK

~140 x 3,000 mm

No.	Equipment	E-W x N-S (mm)	Electrical	Water, drain, gas	Status
O2	Krystal 46.9V convection oven (ref. AF072100273)	900 x 1000	380 V 3PH, ~16 kW (est.)	Water ½", drain, hood	Estimated
P2	HERA-C proofer, 1 trolley (ref. AF0W9200516)	1190 x 760	220 V 1PH, ~2 kW (est.)	Water ½", drain	OLBA list
O1	Bongard 8.64 E rotary oven (ref. AF056200013)	1440 x 1880	Electric 57 kW (E version)	Water ½", drain, hood. Gas version 8.64 MG: 70 kW, gas point to be created	Catalogue sheet
D1	Eris FA divider-rounder (ref. AF00I103012)	1100 x 880	220 V 1PH, ~1.3 kW	—	Estimated
L1	Rhea AUTO-S 650 sheeter on stand (ref. AF000048716)	2380 x 890	220 V 1PH, 0.75 kW	—	Estimated
T1	Work table with flour bins	1300 x 700	—	—	Plan BOQ dimension
C1	Fonto 60 water chiller (ref. AF014100044)	400 x 500	220 V 1PH 60 Hz, ~0.3 kW (est.)	Filtered water ½", drain	Estimated
M1	Spiral mixer 80 L (Spiral Evo 80)	565 x 1150	380 V 3PH, ~3.5 kW (est.)	—	OLBA list
W1	Wall hand basin	300 x 300	—	Cold + hot water, drain	Estimated
F1	Freezer cabinet, 1 door (-18 °C)	700 x 800	220 V 1PH, ~0.5 kW (est.)	—	Estimated
F2	Refrigerated cabinet, 1 door (+4 °C)	700 x 800	220 V 1PH, ~0.4 kW (est.)	—	Estimated
T2	Stainless work table (1,000 x 700)	1000 x 700	—	—	Estimated

Reading the plan

- A single wall to break: the ~140 mm wall between Bakery and Meat area, over the full 3,000 mm depth. North, west, south and east partitions kept.
- A single entrance: the existing 1,190 mm opening, west side, for raw materials and finished product out. The 1,000 mm opening on the east is closed, freeing the east corner for a work table and the hand basin. If you prefer to keep the entrance on the east, the plan has to be redone.
- Consequence: the Meat area disappears. Its equipment (cutting, mincer, tables) has to be relocated, for example by merging Meat and Chicken in the Chicken area.
- The wall is drawn in orange on the original plan (existing wall). Whether it is load-bearing is not indicated: to be validated before demolition. If load-bearing, keep a post and open two bays.
- Both ovens are on the same west wall, doors facing the same aisle: Bongard 8.64 rotary (57 kW electric or 70 kW gas, gas line to be created) and Krystal 46.9V convection, with a single shared hood possible. The proofer is to the south, between the ovens and the divider.

Mixing, sheeting, shaping | Water | Baking | Tables | Proofing | Racks, shelves | Cold

Orange dashed arrow: production flow. Orange dotted: loading zone. Grey dotted: hood. Red hatched: wall to break. Orange line on north wall: existing opening.


Sources: KITCHEN plan of 19-10-2026 (dimensions 4,750, 3,000, 4,000 and openings taken from the PDF). Equipment: see dimension status.

Version C, detail plan

Bakery + 1 m of Meat area, 17.7 m2, scale 1:9.3 on the sheet

KITCHEN - Bakery Egypt

04-11-2026 - scale shown on each plan

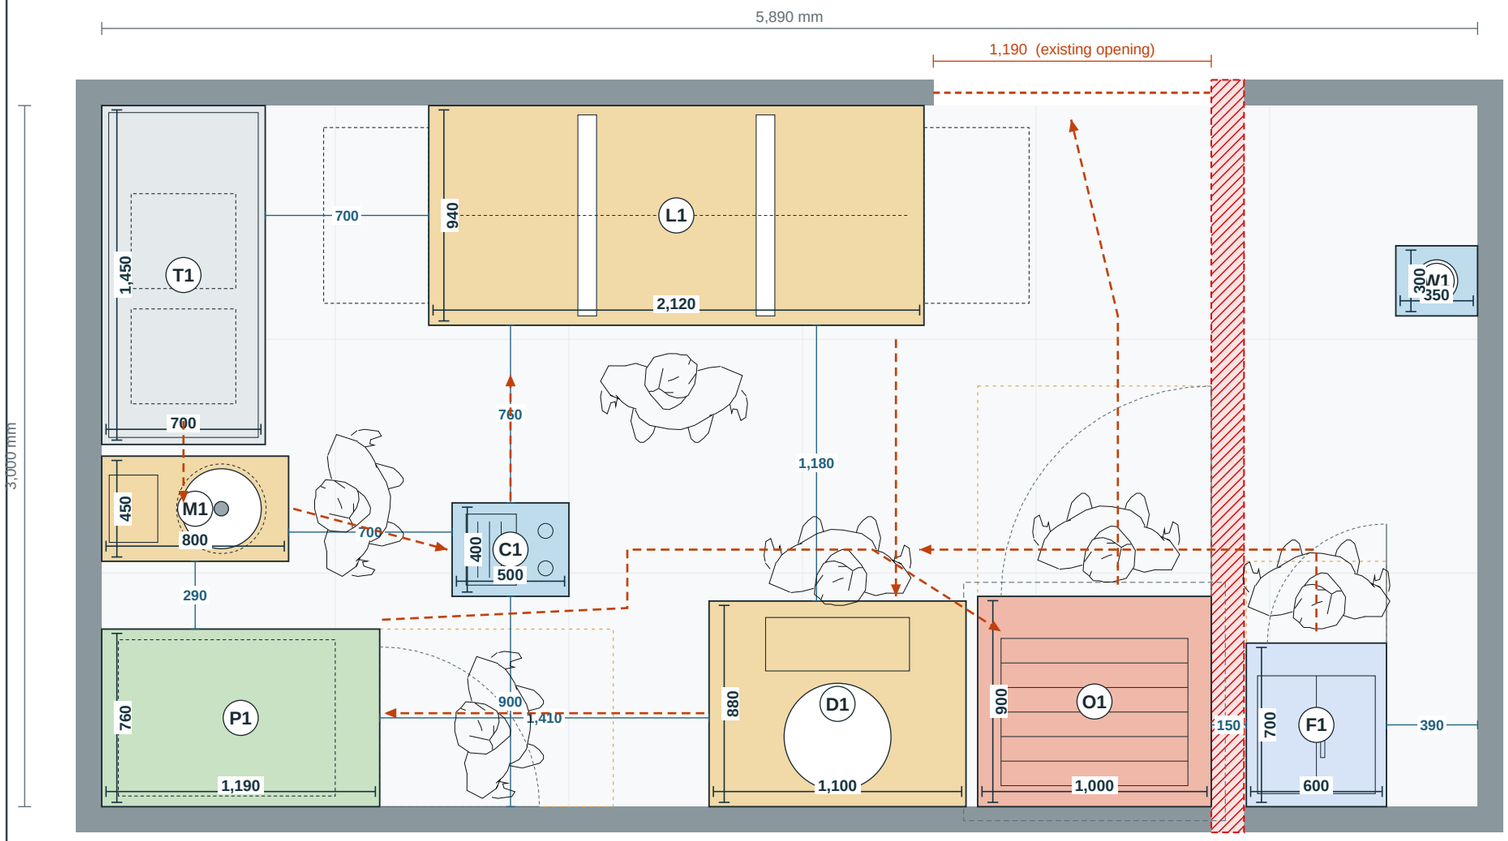

WALL TO BREAK ~140 x 3,000 mm

NEW PARTITION

No.	Equipment	E-W x N-S (mm)	Electrical	Water, drain, gas	Status
L1	Rhea MANU-T 500 sheeter (ref. AF000047424)	2120 x 940	220 V 1PH, ~0.5 kW	—	Estimated
W1	Wall hand basin	350 x 300	—	Cold + hot water, drain	Estimated
P1	HERA-C proofer, 1 trolley (ref. AF0W9200516)	1190 x 760	220 V 1PH, ~2 kW (est.)	Water ½", drain	OLBA list
O1	Krystal 46.9V convection oven (ref. AF072100273)	1000 x 900	380 V 3PH, ~16 kW (est.)	Water ½" (steam), drain, hood	Estimated
D1	Eris FA divider-rounder (ref. AF00I103012)	1100 x 880	220 V 1PH, ~1.3 kW	—	Estimated
T1	Work table with flour bins	700 x 1450	—	—	Plan BOQ dimension
M1	Spiral mixer 40 L (model to be confirmed)	800 x 450	380 V 3PH, ~2 kW (est.)	—	Estimated
C1	Fonto 60 water chiller (ref. AF014100044)	500 x 400	220 V 1PH 60 Hz, ~0.3 kW (est.)	Filtered water ½", drain	Estimated
F1	Undercounter refrigerator, 1 door (+4 °C)	600 x 700	220 V 1PH, ~0.3 kW (est.)	—	Estimated

Reading the plan

- Intermediate version: the 4,750 mm Bakery is extended by 1,000 mm taken from the Meat area, i.e. 5,890 x 3,000 mm (17.7 m2). Same equipment as A, plus the 600 x 700 mm refrigerator, which now fits without blocking a workstation.
- Two works: break the ~140 mm wall between Bakery and Meat area, and build a new partition 5,890 mm from the west corner, closing the Meat area reduced to 3,000 mm wide. Whether the wall is load-bearing must be validated before breaking it.
- A single entrance: the existing 1,190 mm opening, kept clear. Same flow logic as A: flour, mixer, chiller, sheeter, divider, proofer on the west wall, oven. The refrigerator sits beside the oven, to the south.
- The reduced Meat area (3,000 mm) loses space: part of its equipment must be relocated. Machine dimensions are estimated, to be confirmed on datasheets. Production: see page 11.

Mixing, sheeting, shaping · Water · Baking · Tables · Proofing · Racks, shelves · Cold

Orange dashed arrow: production flow. Orange dotted: loading zone. Grey dotted: hood. Red hatched: wall to break. Orange line on north wall: existing opening.

Sources: KITCHEN plan of 19-10-2026 (dimensions 4,750, 3,000, 4,000 and openings taken from the PDF). Equipment: see dimension status.

Production volumes

Capacity per step in pieces per hour (1 piece = about 80 g of dough) over 6.3 productive hours a day, basis of the NABAT v5.0 workbook. The bottleneck of the chain gives the real volume.

Step	Versions A and C	Version B	Source
Baking	Krystal convection: 250	Rotary 563 + convection 250 = 813	Rotary: workbook; convection: estimated
Mixing	Spiral 40 L: 400	Spiral 80 L: 800	80 L: workbook; 40 L: half of the 80 L
Dividing	Eris FA: 1200	Eris FA: 1200	Workbook
Sheeting (croissants)	Bench sheeter: 300	Rhea AUTO-S 650: 700	AUTO-S: workbook; bench: estimated
Proofing	**HERA-C 1 trolley: 144**	**HERA-C 1 trolley: 144 (current plan)**	1 trolley = 180 pieces per 75 min cycle, estimated

Current bottleneck: the proofer, identical in A, C and B.

VERSIONS A AND C

Current plan, 1-trolley proofer — **73 kg**
144 /h - 907 pieces per day

Proofing topped up with trolleys at room temperature — **126 kg**
250 /h - 1,575 pieces per day

VERSION B

Current plan, 1-trolley proofer — **73 kg**
144 /h - 907 pieces per day

Double-trolley proofer — **145 kg**
288 /h - 1,814 pieces per day

Proofing 4 trolleys in cycle — **290 kg**
576 /h - 3,629 pieces per day

Ceiling of both ovens — **410 kg**
813 /h - 5,122 pieces per day

kg of dough per day = pieces x 80 g, over 6.3 productive hours.

Key point: the ovens of B are 3.3 times those of A, but plan B keeps a single proofer. Without changing the proofer, B produces no more than A.

To reach about 300 kg a day in B, proofing must handle 4 trolleys in cycle (double trolley, two units, or trolleys at room temperature). Proposal: replace the proofer of B with a double-trolley model.

Estimates to confirm on Bongard/BME datasheets: convection oven output, proofing cycle, pieces per trolley.

Equipment price estimate

Prices in SAR excl. 15 % VAT, taken from the NABAT-CK-MEL-001 v5.0 workbook (Bongard / BME, Restofair, Natfur). Central Kitchen pricing: to be reconfirmed for the bakery (quantity 1).

Version A, compact (14.25 m2)

No.	Equipment	BME reference	Price SAR	Price status	Note
L1	Rhea MANU-T 500 sheeter	AF000047424	26,420	BME quote	NABAT v5.0 workbook
D1	Eris FA divider-rounder	AF00I103012	78,320	BME quote	NABAT v5.0 workbook
P1	HERA-C proofer, 1 trolley	AF0W9200516	41,200	BME quote	NABAT v5.0 workbook
O1	Krystal 46.9V convection oven	AF072100273	42,900	BME quote	NABAT v5.0 workbook
O1	Krystal hood	AF072181002	8,280	BME quote	Unit price of the "KRYSTAL hood x2" line
O1	Stand Krystal H850	AF072306711	4,120	BME quote	Option
T1	Work table with flour bins	—	4,960	Estimated	Stainless table 180x70 (4,410) + 81 L flour bin (550)
M1	40 L spiral mixer	to be confirmed	to quote	To quote	No 40 L line; the 80 L is 58,340
C1	Fonto 60 water chiller	AF014100044	28,460	BME quote	NABAT v5.0 workbook
C1	Fonto 60 base	AF014100052	3,196	BME quote	Option
W1	Stainless hand basin	HW001	1,000	Estimated	Range 850 to 1,200
	Total excluding lines to quote		**238,856**	1 line to quote, not included	

Version C, intermediate (17.7 m2)

No.	Equipment	BME reference	Price SAR	Price status	Note
L1	Rhea MANU-T 500 sheeter	AF000047424	26,420	BME quote	NABAT v5.0 workbook
D1	Eris FA divider-rounder	AF00I103012	78,320	BME quote	NABAT v5.0 workbook
P1	HERA-C proofer, 1 trolley	AF0W9200516	41,200	BME quote	NABAT v5.0 workbook
O1	Krystal 46.9V convection oven	AF072100273	42,900	BME quote	NABAT v5.0 workbook
O1	Krystal hood	AF072181002	8,280	BME quote	Unit price of the "KRYSTAL hood x2" line
O1	Stand Krystal H850	AF072306711	4,120	BME quote	Option
T1	Work table with flour bins	—	4,960	Estimated	Stainless table 180x70 (4,410) + 81 L flour bin (550)
M1	40 L spiral mixer	to be confirmed	to quote	To quote	No 40 L line; the 80 L is 58,340
C1	Fonto 60 water chiller	AF014100044	28,460	BME quote	NABAT v5.0 workbook
C1	Fonto 60 base	AF014100052	3,196	BME quote	Option
W1	Stainless hand basin	HW001	1,000	Estimated	Range 850 to 1,200
F1	Undercounter refrigerator, 1 door	—	5,100	Estimated	Restofair "Undercounter 1,500 mm" line
	Total excluding lines to quote		**243,956**	1 line to quote, not included	

Version B, enlarged (26.7 m2)

No.	Equipment	BME reference	Price SAR	Price status	Note
O1	Bongard 8.64 E rotary oven	AF056200013	161,200	BME quote	NABAT v5.0 workbook; hood not priced
O2	Krystal 46.9V convection oven	AF072100273	42,900	BME quote	NABAT v5.0 workbook
O2	Krystal hood	AF072181002	8,280	BME quote	Unit price
O2	Stand Krystal H850	AF072306711	4,120	BME quote	Option
P2	HERA-C proofer, 1 trolley	AF0W9200516	41,200	BME quote	NABAT v5.0 workbook
D1	Eris FA divider-rounder	AF00I103012	78,320	BME quote	NABAT v5.0 workbook
L1	Rhea AUTO-S 650 sheeter on stand	AF000048716	94,800	BME quote	NABAT v5.0 workbook
T1	Work table with flour bins	—	4,960	Estimated	Stainless table 180x70 (4,410) + 81 L flour bin (550)
T2	Stainless work table	AF000046872	4,410	BME quote	Stainless table 180x70
M1	Spiral Evo 80 L spiral mixer	AF00A110200 (200 L) / 80 L	58,340	BME quote	SPIRAL EVO 80L line
C1	Fonto 60 water chiller	AF014100044	28,460	BME quote	NABAT v5.0 workbook
C1	Fonto 60 base	AF014100052	3,196	BME quote	Option
F1	Freezer cabinet, 1 door	—	to quote	To quote	No line in the workbook
F2	Refrigerated cabinet, 1 door	—	6,900	Estimated	Restofair "Upright Chiller 2 doors" line
W1	Stainless hand basin	HW001	1,000	Estimated	Range 850 to 1,200
	Total excluding lines to quote		**538,086**	1 line to quote, not included	

Read with caution: workbook prices are for a Central Kitchen; Estimated lines come from another workbook line or a range, not from a quote. Installation, hoods and gas not included unless stated.